

SECOND FLOOR PLAN  
SCALE 1/8" = 1'-0"

Revisions	
Item	Date

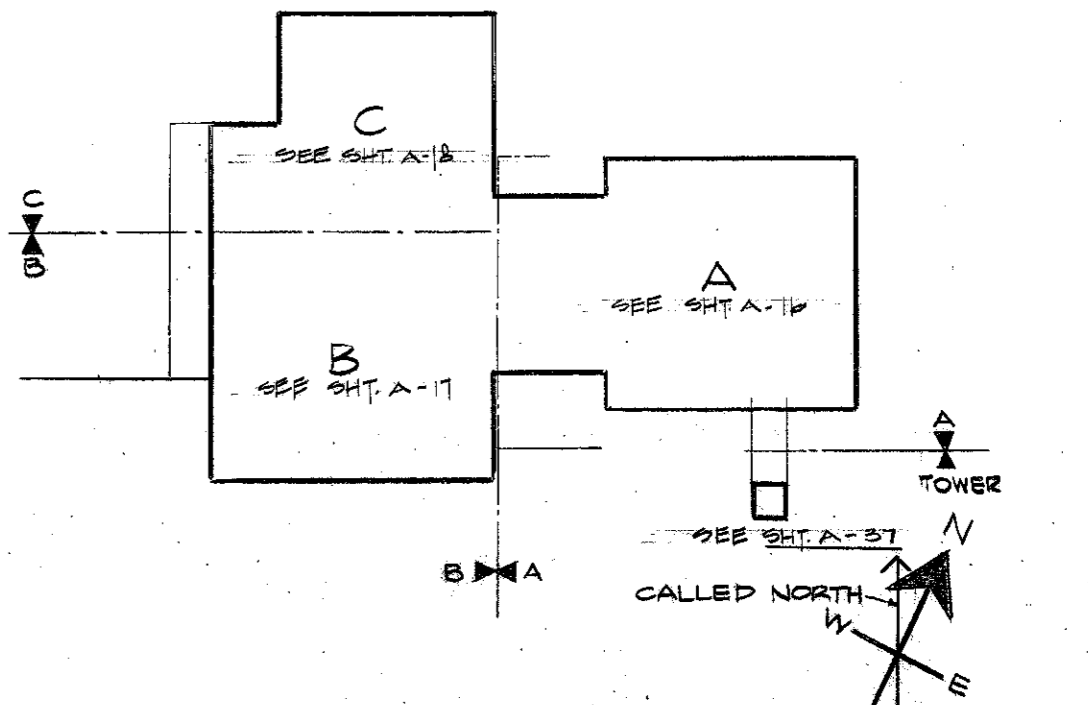
Sheet Contents: SECOND FLOOR PLAN 1/8" = 1'-0"	Approved: <i>[Signature]</i> Agency: <i>[Signature]</i> Job Capt.: <i>[Signature]</i> Section Head: <i>[Signature]</i> Agency Director: <i>[Signature]</i> Date: 7-9-1970
---	--

Prepared by: DURHAM · ANDERSON · FREED ARCHITECTS · AIA 1100 BENNY WAY · SEATTLE, WASHINGTON	Project Title: THE EVERGREEN STATE COLLEGE WASHINGTON OLYMPIA A 15 THE LIBRARY BUILDING
---	---

State Job No.: 65-616 Sheet No.: A 15	AS BUILT DRAWING
--	------------------



REV.	DATE	BY	CHK.
1-7-76		RR	