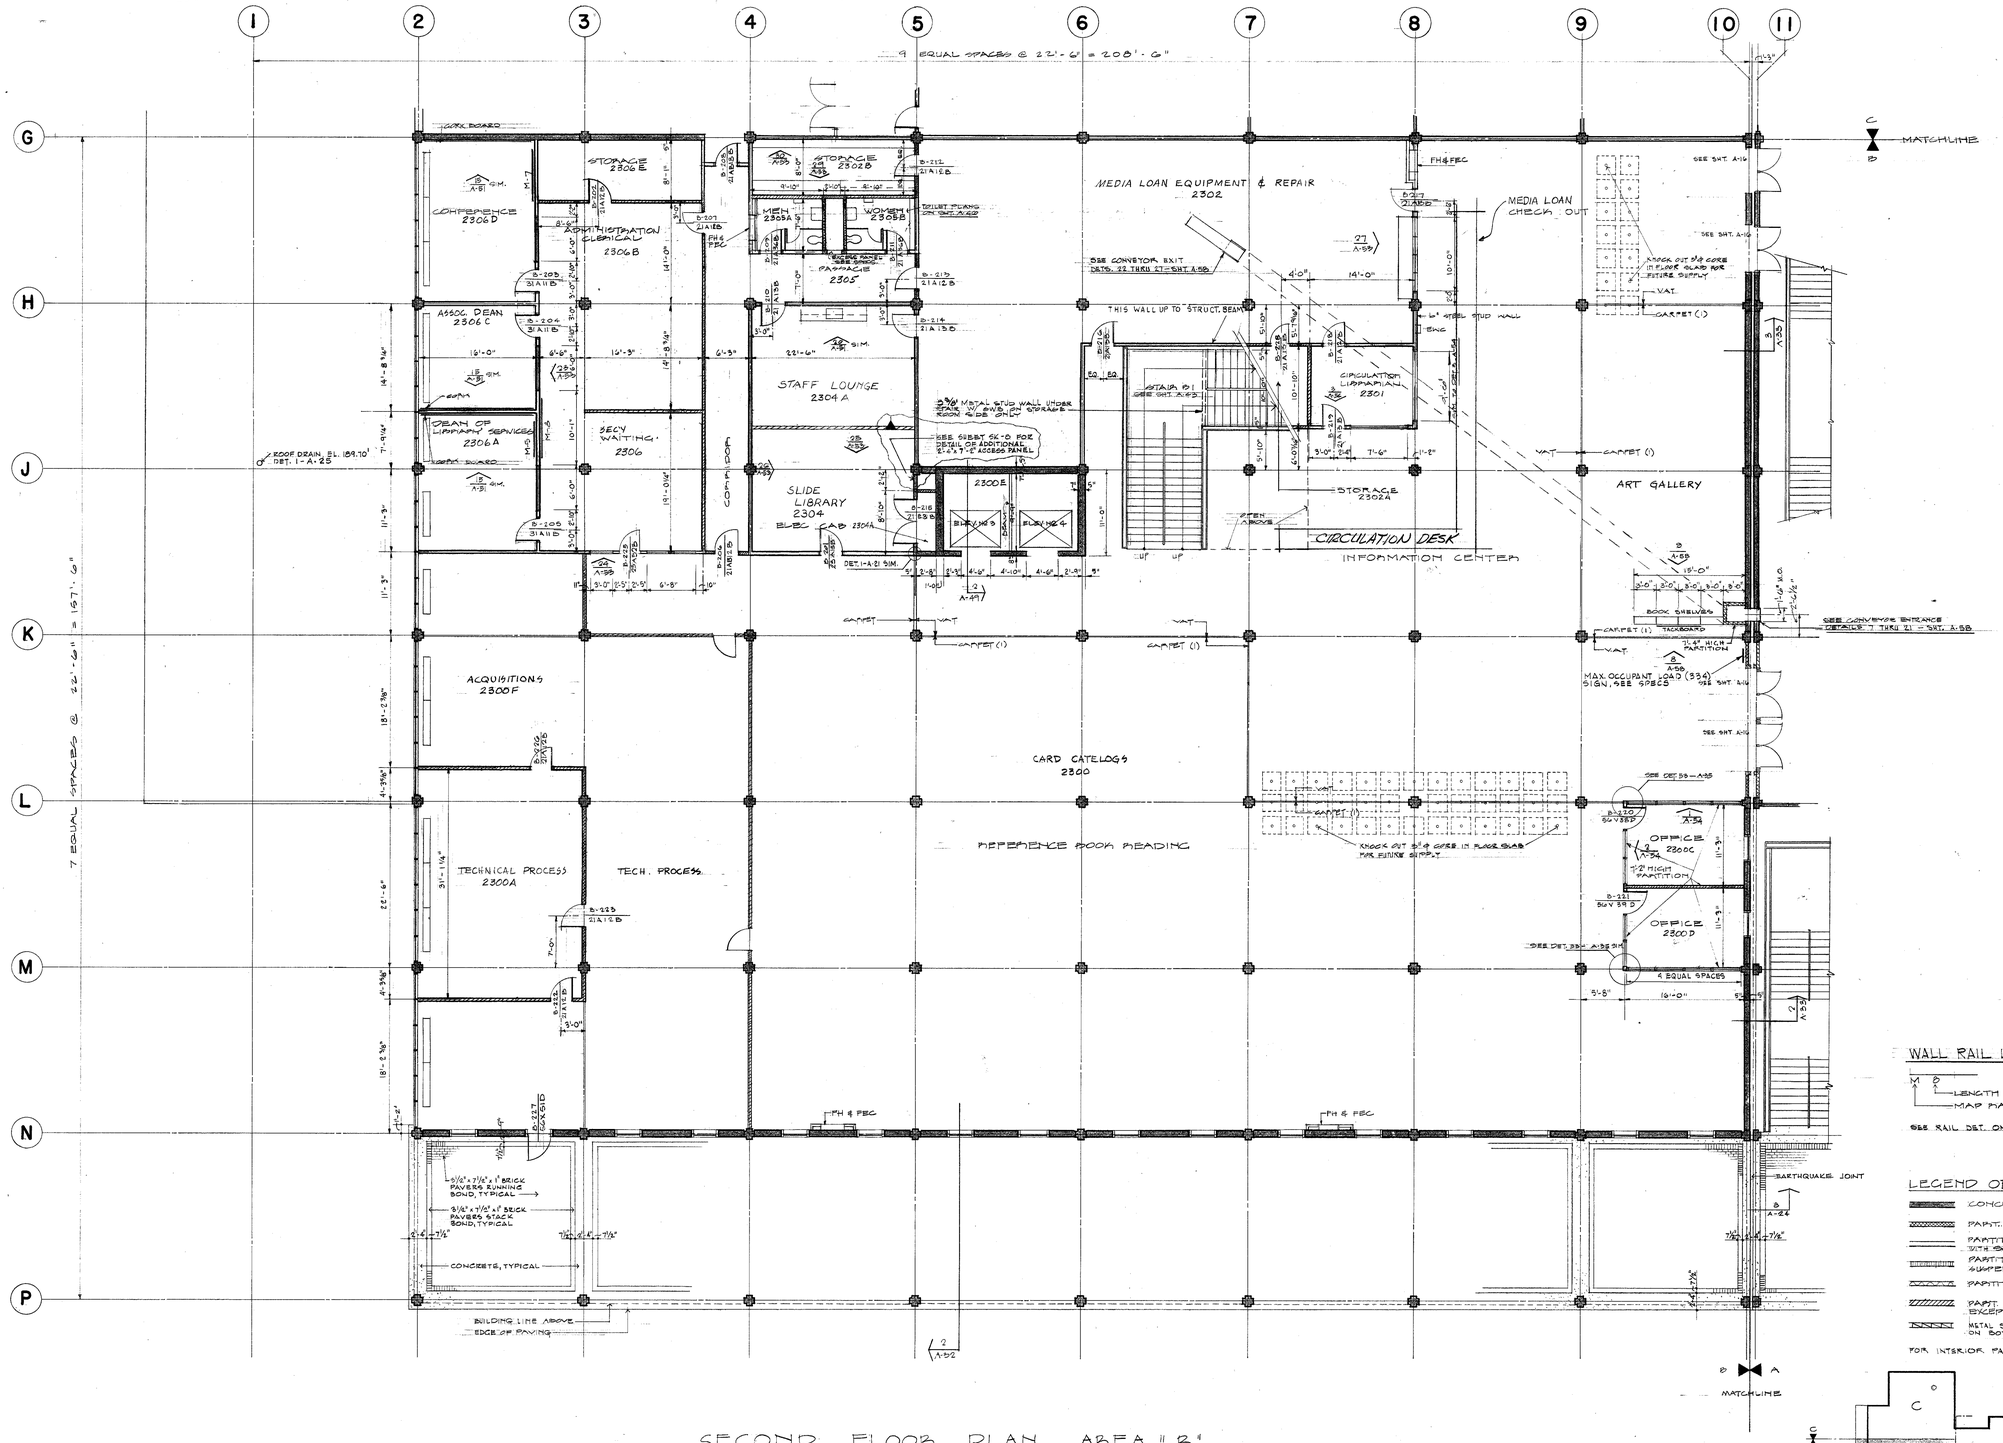

SECOND FLOOR PLAN AREA "B"
SCALE 1/8" = 1'-0"

WALL RAIL LEGEND

LENGTH OF RAIL
MAP RAIL DET. 21

SEE RAIL DET. ON SHT. A-5A

LEGEND OF WALL SYMBOLS

- CONCRETE
- PART. TYPE #1 UP TO STRUCT. SLAB
- PARTITION TYPE #2, UP TO GLG. WITH SOUND BARRIER ABOVE
- PARTITION TYPE #2, UP TO ACOUSTICAL CEILING
- PARTITION TYPE #3
- PART. TYPE #1, UP TO SUSP. CLG. EXCEPT OTHERWISE NOTED
- METAL STUD WALL W/ DOUBLE GWB ON BOTH SIDES (2 HR. WALL)

FOR INTERIOR PARTITION SEE SHT. A-4

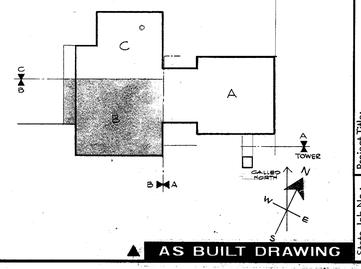

▲ AS BUILT DRAWING

D3-14 2ND FL. "D" 1/8"=1'-0"

Revisions			
Issue	Date		
Item			
Drawn: WLS, DY			
Traced: WLS, DY			
Checked: JEB			
Date: 1-9-1970			

Sheet Contents: SECOND FLOOR PLAN AREA "B" 1/8" = 1'-0"

Approvals:
Agency:
Job Capt.:
Section Head:
Agency Director:
Spvr. of Eng. & Arch.:

STATE OF WASHINGTON — DEPARTMENT OF GENERAL ADMINISTRATION — DIV. OF ENGINEERING & ARCHITECTURE

Project Title: THE EVERGREEN STATE COLLEGE OLYMPIA WASHINGTON
THE LIBRARY BUILDING

Prepared by: DURHAM · ANDERSON · FREED ARCHITECTS · AIA
1100 DENNY WAY · SEATTLE, WASHINGTON

REGISTERED ARCHITECT ROBERT L. DURHAM STATE OF WASHINGTON TL 3691

State Job No.: 68-676
Sheet No.: A-17

NO.	REV.	KR
	7-76	

DIK17

D5-1-012