D5-1-020

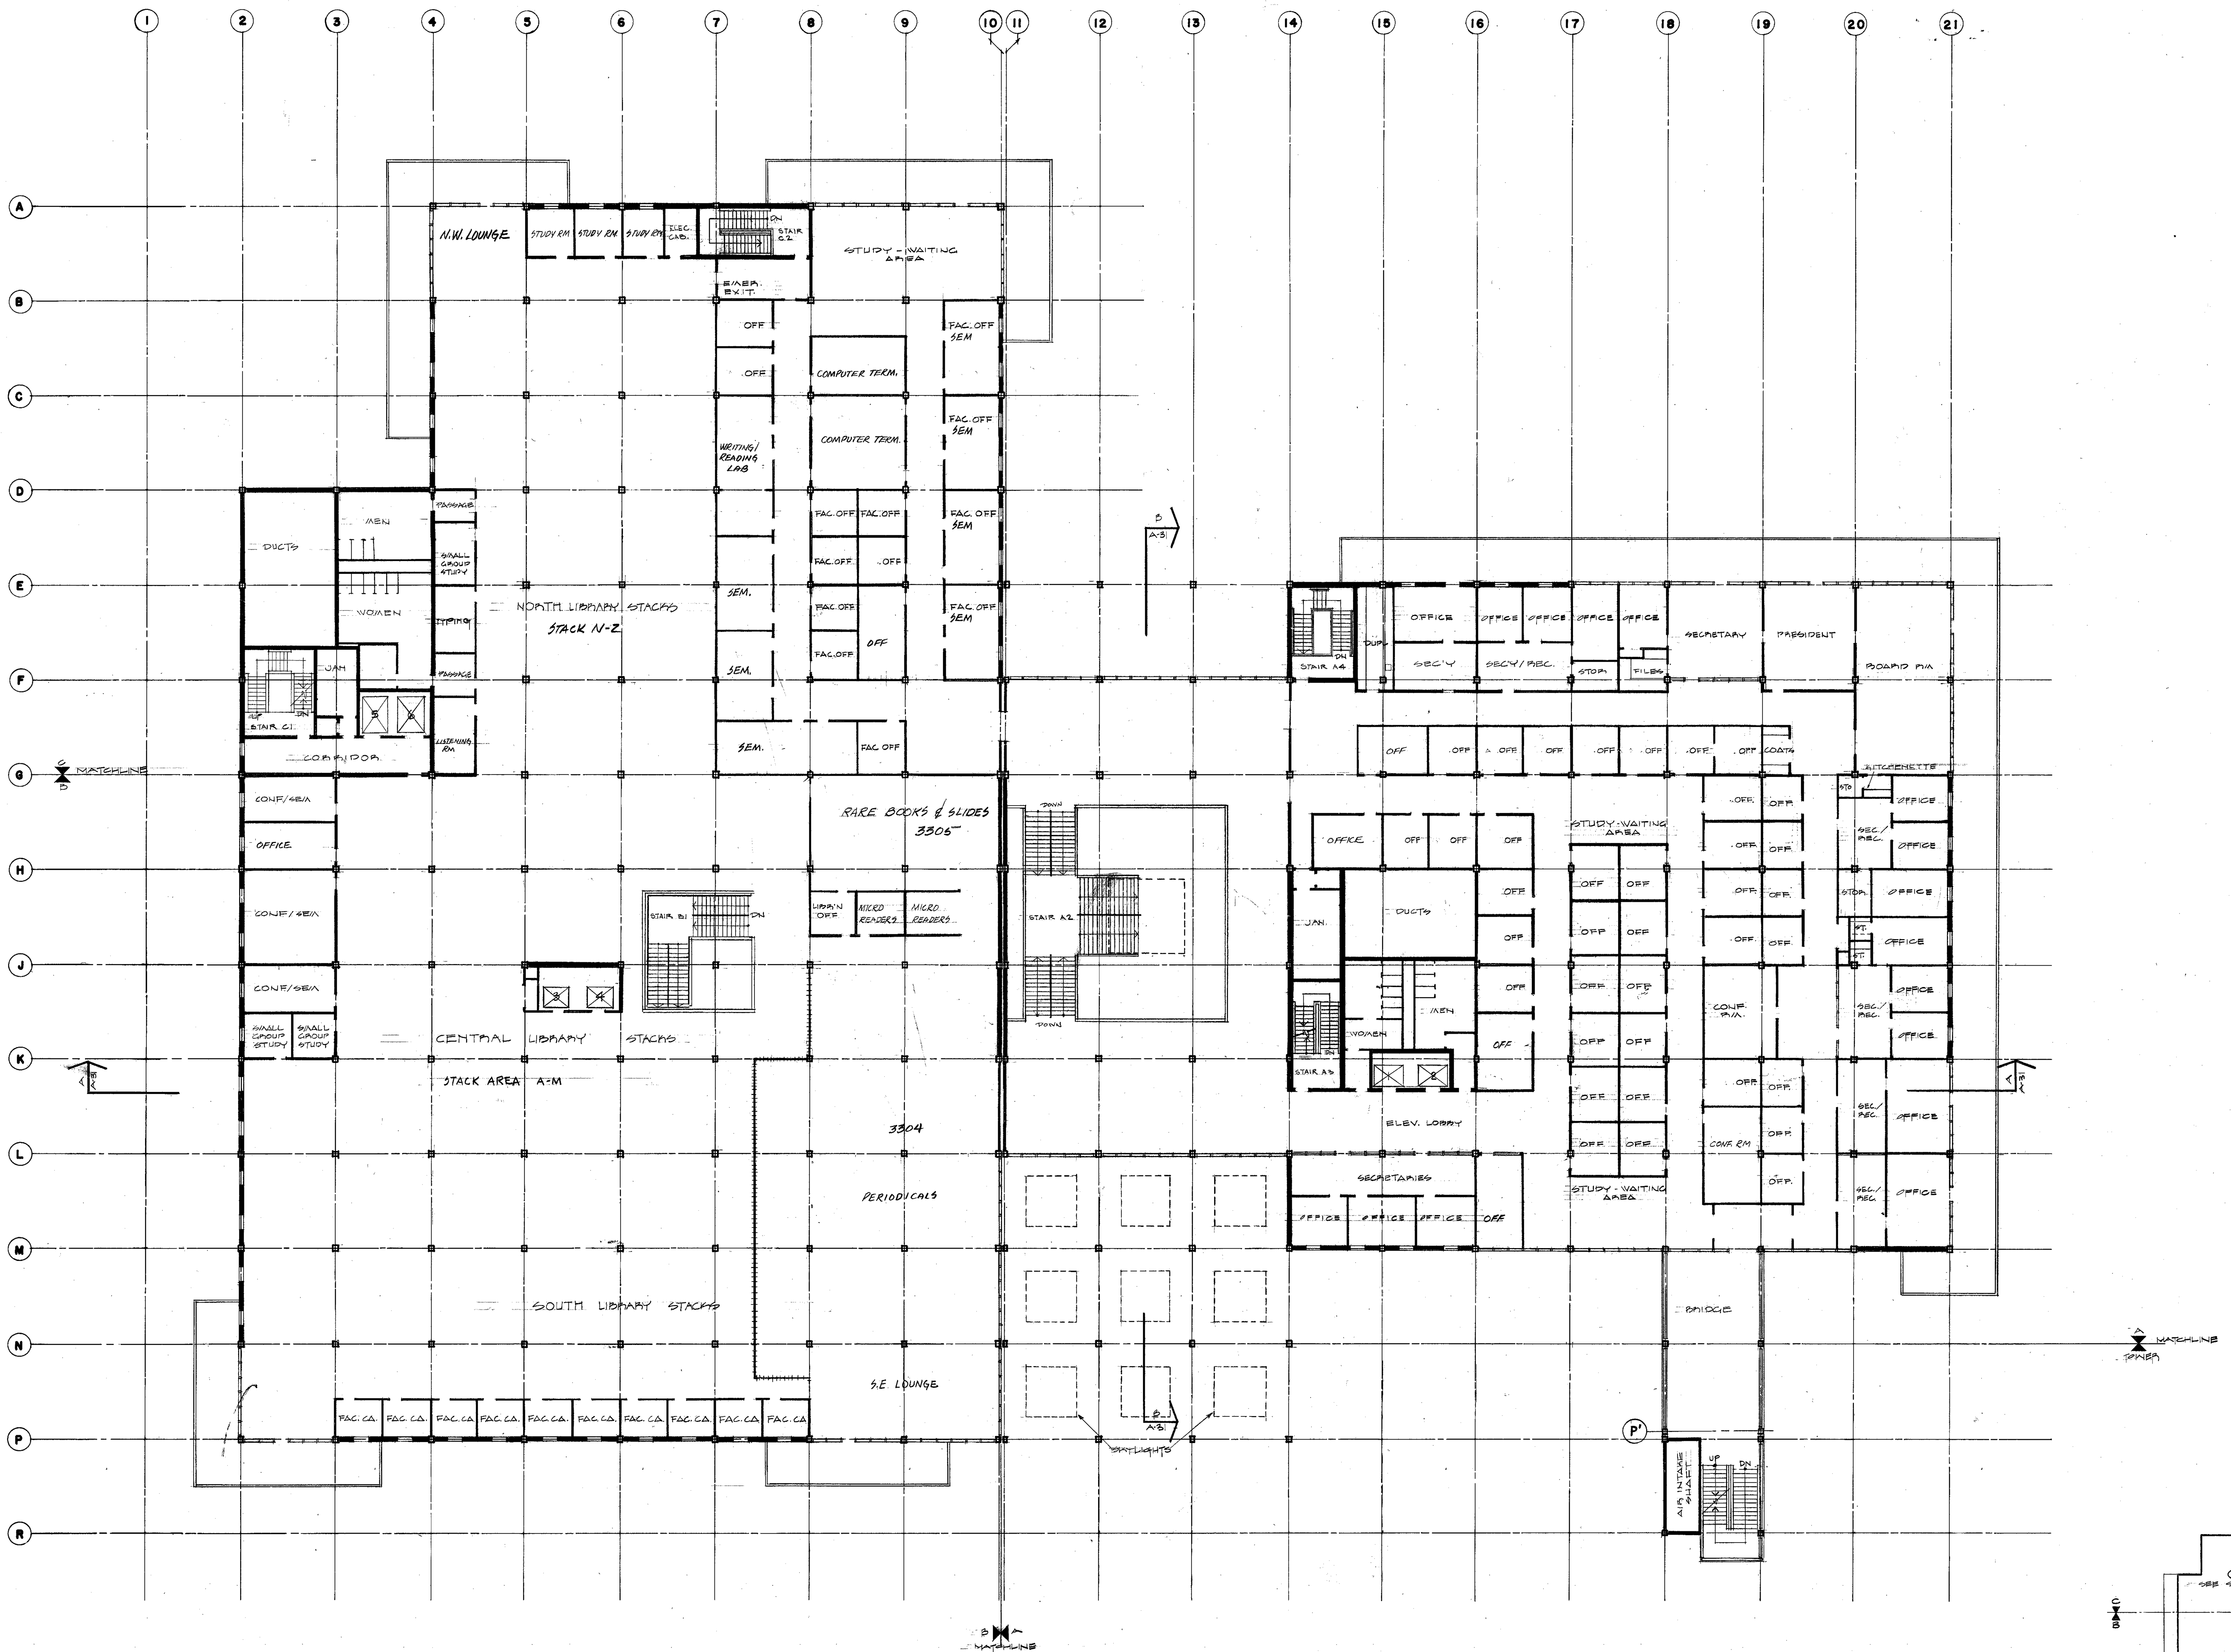

THIRD FLOOR PLAN
SCALE 1/16" = 1'-0"

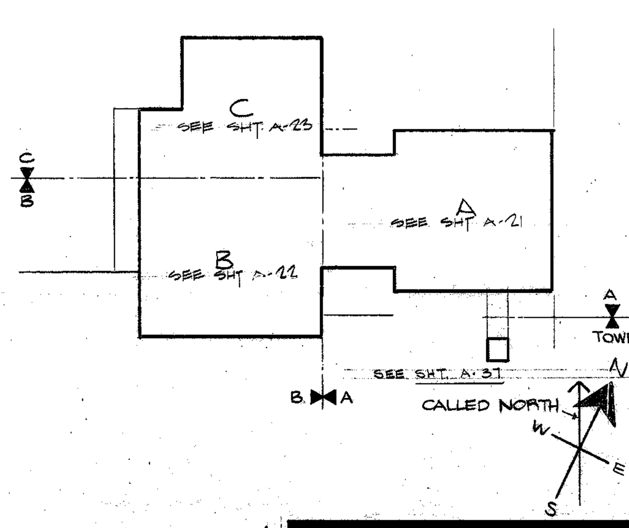

7-76	REV.	KR
DATE	TO	NO.

AS BUILT DRAWING

Revisions

Issue	Date	Item

Sheet Contents: THIRD FLOOR PLAN 1/16" = 1'-0"

Approvals:
Agency:
Job Capt.:
Section Head:
Agency Director:
Supv. of Eng. & Arch.:

Drawn: KS, DY
Traced: KS, DY
Checked: JEB
Date: 1-9-1970

Prepared by:
DURHAM · ANDERSON · FREED
ARCHITECTS · AIA
1100 DENNY WAY · SEATTLE, WASHINGTON

REGISTERED ARCHITECT
ROBERT L. DURHAM
STATE OF WASHINGTON

Project Title:
THE EVERGREEN STATE COLLEGE
OLYMPIA WASHINGTON
THE LIBRARY BUILDING

State Job No.: 68-676
Sheet No.: A-20

STATE OF WASHINGTON — DEPARTMENT OF GENERAL ADMINISTRATION — DIV. OF ENGINEERING & ARCHITECTURE

D3-H 3RD FL. 1/16"=1'-0"